

LOT 30.1, BLOCK 1,
SECTION 392
193,243 sq. ft.
4.436 acres

- GENERAL NOTES**
- LOCATIONS OF UTILITIES AND CONCRETE FOUNDATIONS OBTAINED BY MASER CONSULTING P.A. THE FOLLOWING DATES: 7/31/08, 8/27/08, 9/02/08, 9/08/08, & 9/17/08
 - OTHER CONDITIONS SHOW HEREON BASED ON A MAP ENTITLED, "MAP OF PROPERTY, SITUATED AT BAYSHORE, TOWN OF ISLIP, SUFFOLK COUNTY, NEW YORK, DATED AUGUST 8, 2007, AND PREPARED BY NELSON AND POPE.
 - HORIZONTAL DATUM NEW YORK STATE PLANE COORDINATE SYSTEM NAD 1927, VERTICAL DATUM NGVD 1929

- LEGEND**
- UTILITY POLE
 - UTILITY GUY
 - SMH ○ SANITARY MANHOLE
 - FIRE HYDRANT
 - WATER METER
 - WATER VALVE
 - SIGNAL POLE
 - TMH ○ TELEPHONE MANHOLE
 - TELEPHONE LINE
 - WATER MAIN
 - GAS MAIN
 - PROPERTY BOUNDARY LINE
 - TW 20.2 ○ TOP OF WALL ELEVATION
 - (T.O.P.22.4) ○ TOP OF PIPE ELEVATION
 - D.I.P. ○ DUCTILE IRON PIPE
 - B.EX. ○ BOTTOM OF EXCAVATION
 - T.EX. ○ TOP OF EXCAVATION

MASER
Consulting, Municipal & Environmental Engineers
Planners • Surveyors • Landscape Architects
State of N.J. Certificate of Authorization: 24GA27886500

RED BANK OFFICE
331 Newman Springs Road
Suite 203
Red Bank, N.J. 07701
Phone (732) 383-1950
Fax (732) 383-1984
E-mail - solutions@maserconsulting.com

Regional Office
Clinton, N.J.
Hamilton, N.J.
Logan, N.J.
Mt. Arlington, N.J.
West Nyack, N.Y.
Newburgh, N.Y.
Bethlehem, PA.


ABANDONED UTILITIES AND FOUNDATIONS FOR ENACT NATIONAL GRID US BAY SHORE FORMER MANUFACTURED GAS PLANT SITE PHASE II, QU-1 REMEDIAL ACTIONS SITUATE IN:
TOWN OF ISLIP SUFFOLK COUNTY NEW YORK

JOB NUMBER: 08000278A
SCALE: 1"=20'
SHEET NUMBER: 3 of 6

DATE: OCT 13, 2008
LATEST REVISION: APRIL 16, 2009
DESIGN BY: D.J.M.

LEONARDO E. PONZIO
NEW YORK PROFESSIONAL LAND SURVEYOR LIC. NO. 056292-1

REV.	DATE	DRAWN BY	DESCRIPTION
3.	4/16/09	RTH	GENERAL REVISIONS
2.	11/20/08	DJM	GENERAL REVISIONS
1.	10/28/08	RTH	GENERAL REVISIONS

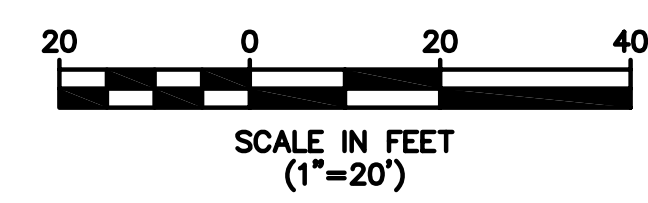

COPYRIGHT © 2008, MASER CONSULTING P.A. - ALL RIGHTS RESERVED.
 THIS DOCUMENT IS THE PROPERTY OF MASER CONSULTING P.A. AND IS NOT TO BE REPRODUCED OR TRANSMITTED IN ANY FORM OR BY ANY MEANS, ELECTRONIC OR MECHANICAL, INCLUDING PHOTOCOPYING, RECORDING, OR BY ANY INFORMATION STORAGE AND RETRIEVAL SYSTEM, WITHOUT THE WRITTEN PERMISSION OF MASER CONSULTING P.A.